

21/12/2015
6 x slope
126 logement

± 60 pt. ent.
± 100 ext.

50%
30%
20%

Ratio = 1.5

STA = 189

IMPLANTATION DONNACONA


PILL VELLEUX

IMPLANTATION OPTION #3
Echelle 1/200 = 1'-0"

30 AVRIL 2015

PAGE 1/1

option A

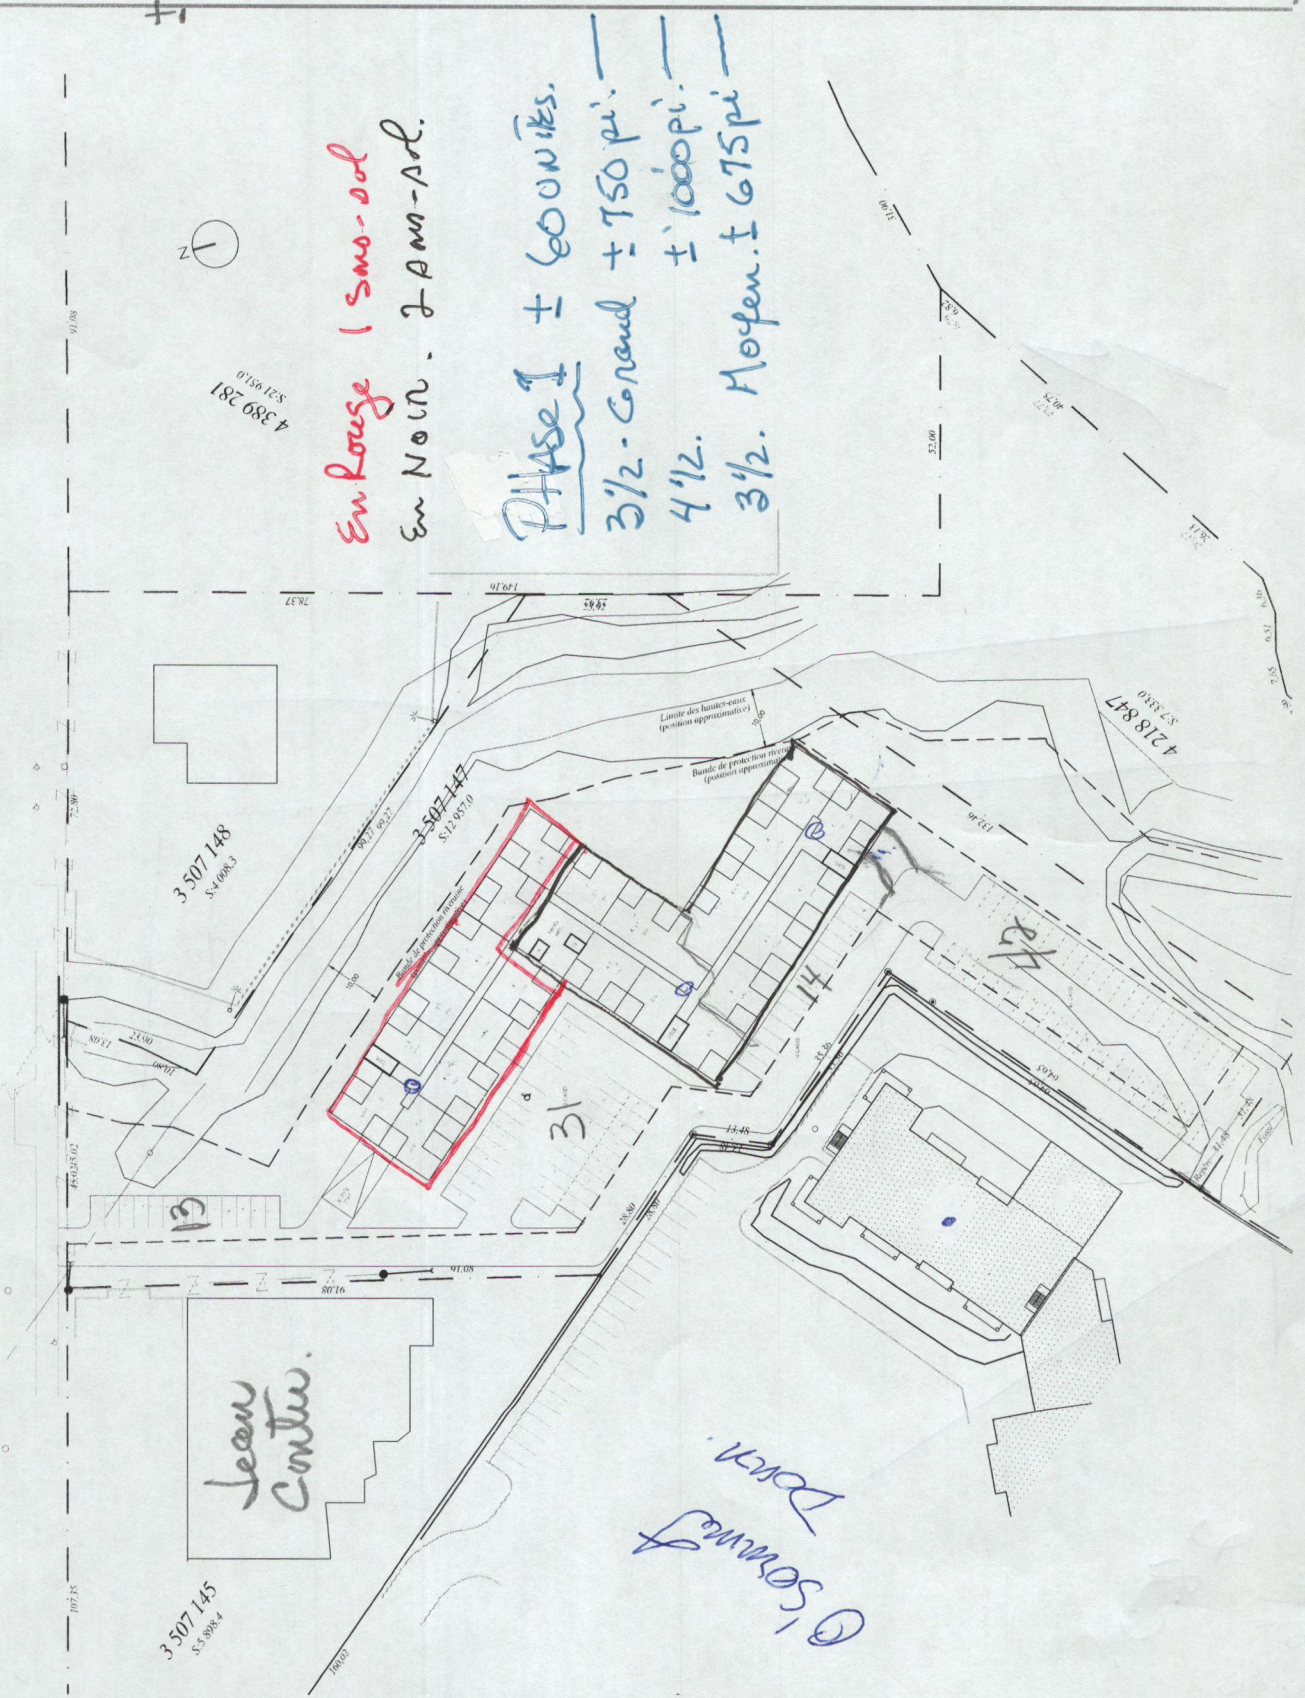

En rouge (smo-ool)
En Noir. 2 AM-Ad.

Phase 1 ± 6000 m²

3 1/2 - Grand ± 750 pi.

4 1/2 - Moyen ± 1000 pi.

3 1/2 - Moyen ± 675 pi.

Jean Contu.

© Sommet
Donnac

3 507 145
S 5 898.4

3 507 148
S 4 008.2

3 507 147
S 12 957.0

4 218 847
S 7 330.0

13

31

14

